


Proposed Changed to Precinct Boundaries

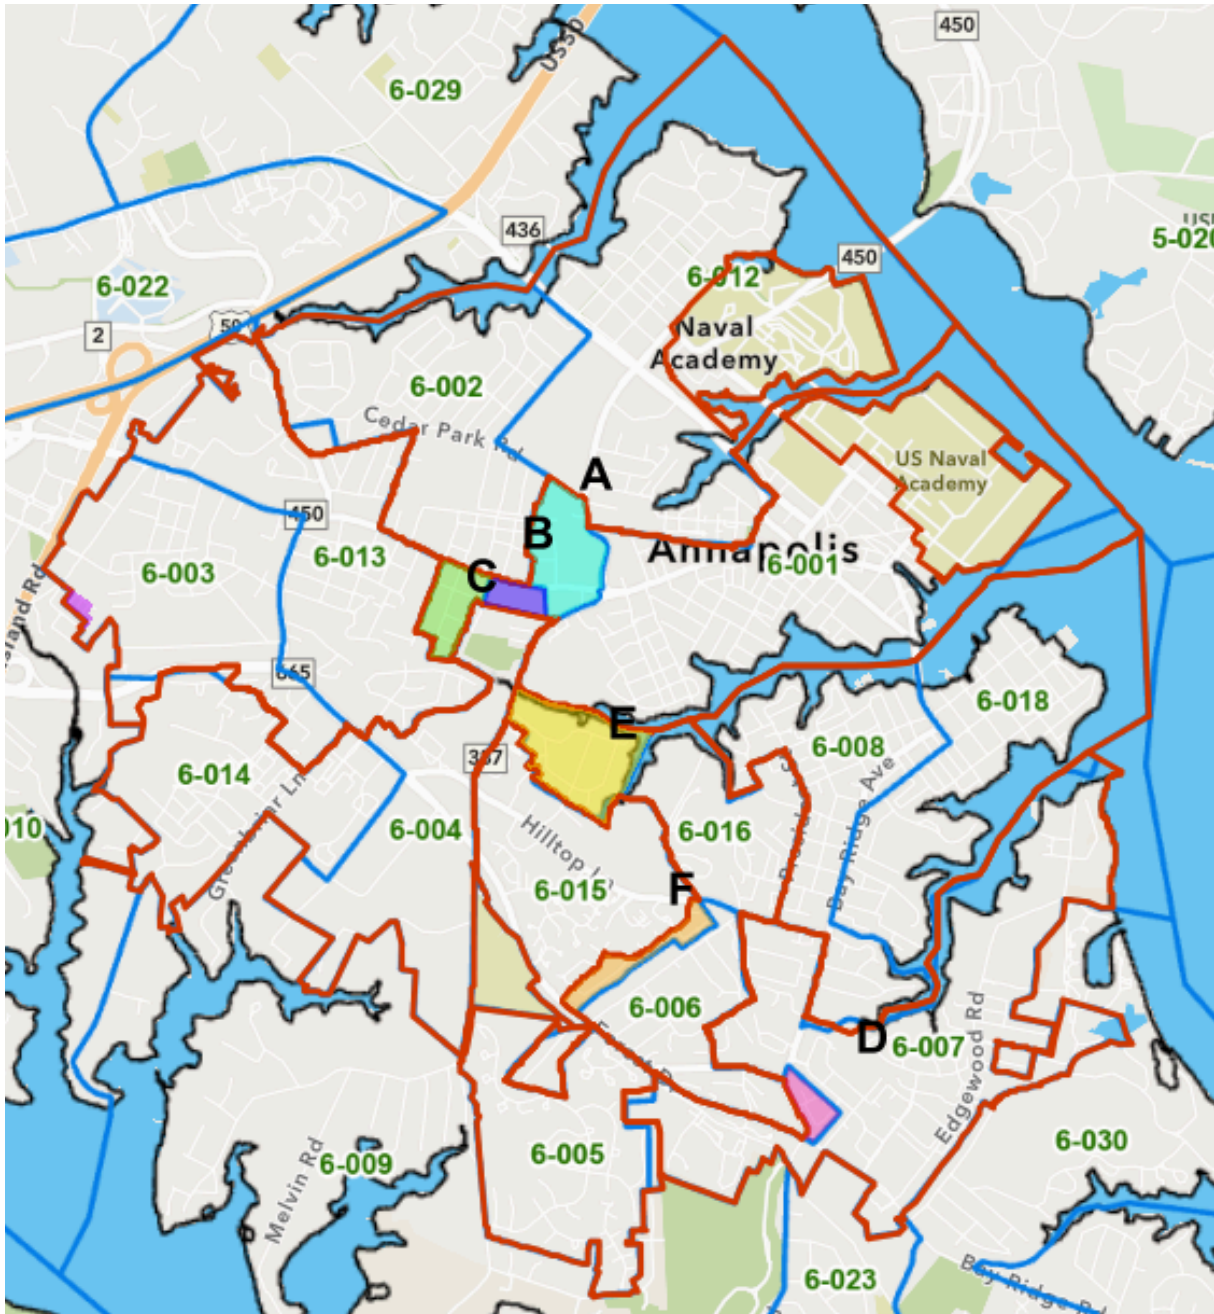


Red Border shows new City of Annapolis ward boundaries

Blue Border shows existing precinct boundaries

Colored sections show areas with precinct boundary changes:

- | | |
|-----------|--------------------------|
| A. Aqua | 06-012 changed to 06-001 |
| B. Purple | 06-004 changed to 06-001 |
| C. Green | 06-013 changed to 06-001 |
| D. Pink | 06-006 changed to 06-007 |
| E. Yellow | 06-001 changed to 06-016 |
| F. Orange | 06-006 changed to 06-015 |


2024 Precinct Boundaries & Former City of Annapolis Ward Boundaries

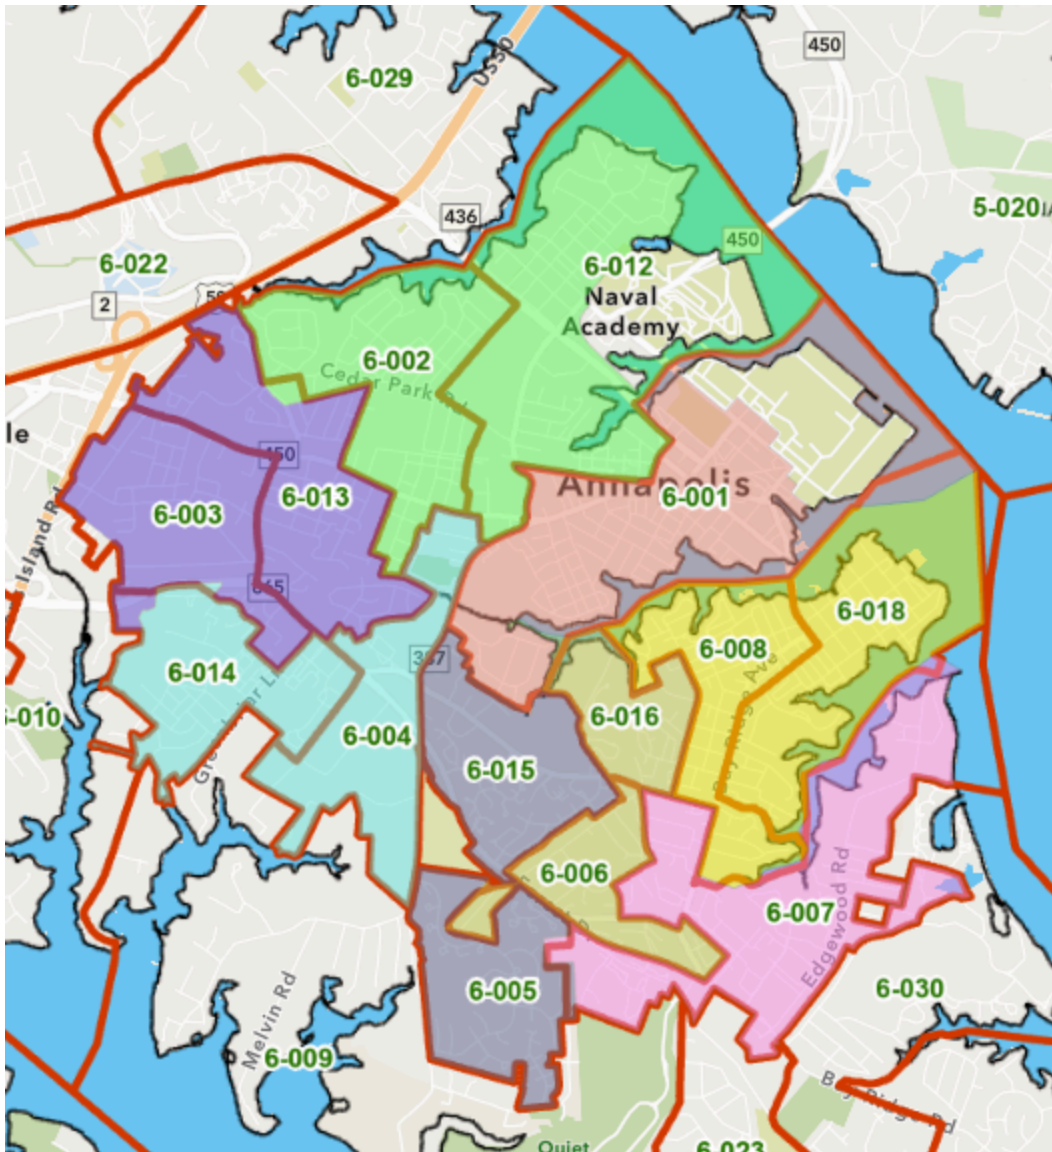

Red line shows precinct boundaries

WARD	PRECINCT(S)
1	06-001
2	06-002 & 06-012
3	06-003 & 06-013
4	06-004 & 06-014
5	06-005 & 06-015
6	06-006 & 06-016
7	06-007
8	06-008 & 06-018

2024 Precinct Boundaries and Updated City of Annapolis Ward Boundaries

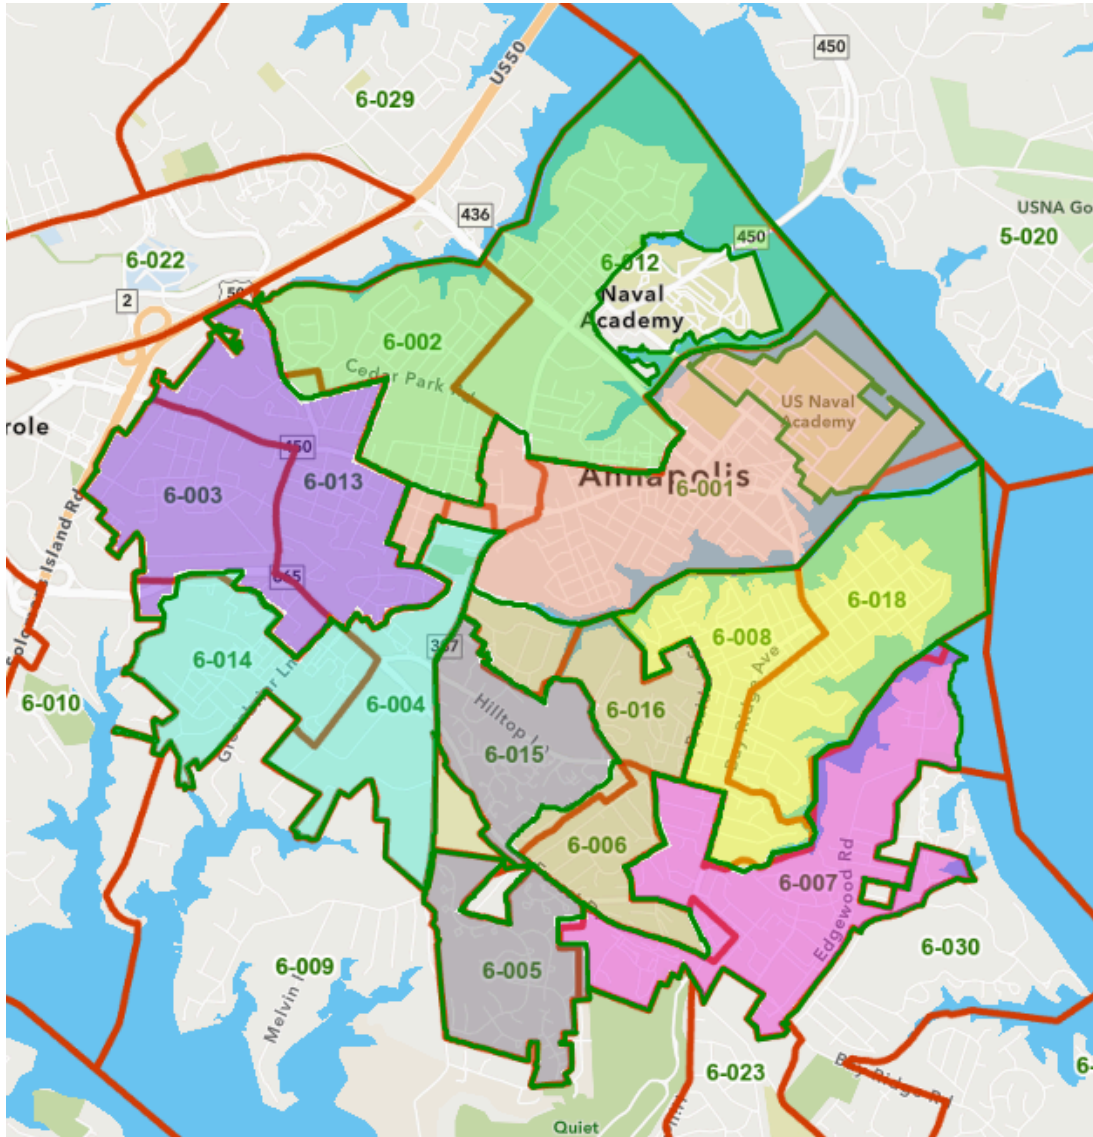

Red line shows precinct boundaries

WARD	PRECINCT(S)
1	06-001
2	06-002 & 06-012
3	06-003 & 06-013
4	06-004 & 06-014
5	06-005 & 06-015
6	06-006 & 06-016
7	06-007
8	06-008 & 06-018

Annapolis Redistricting -
Adjusting Precinct Boundaries to Match City of Annapolis Ward Boundaries